



RECEIVED E-Mail

SEP 23 2014

Div. of Oil, Gas & Mining

September 23, 2014

Vicky Southwick, Executive Secretary, Mining Program  
Department of Natural Resources  
Division of Oil, Gas & Mining  
1594 West North Temple, Suite 1210  
Salt Lake City, Utah 84114-5801

Subject: ECDC Clay Mine (M/015/062) Annual Report for 2013

Dear Vicky:

As per state rule: R647-4-121, please find enclosed the annual report for the referenced clay mine. Also included is a site vicinity map. The map shows the location of the clay mine.

The mine is currently active; however no mining activity has taken place since summer of 2000. Currently there is approximately 1,000 CY of clay remaining in a stockpile.

No reclamation or disturbance has occurred during the reporting period. If you have any questions of need additional information please call me at 435-888-4115.

Sincerely,

A handwritten signature in black ink, appearing to read "D Olson", written over a horizontal line.

Darin Olson  
ECDC Environmental Manager



Wayne

STATE OF UTAH  
DEPARTMENT OF NATURAL RESOURCES  
DIVISION OF OIL, GAS AND MINING  
1594 West North Temple - Suite 1210  
Box 145801  
Salt Lake City, Utah 84114-5801  
Telephone: (801) 538-5291  
Fax: (801) 359-3940

LARGE MINING OPERATIONS PROGRESS REPORT

January 1, 2013 to December 31, 2013

The information required in this form is based on provisions of the Mined Land Reclamation Act, Title 40-8, and the R647 rules under the Utah Minerals Regulatory Program. It is due January 31 of each year.

1. Mine Permit Number: M/015/0062  
2. Mine Name: ECDC CLAY MINE  
3. Name of Operator/Permittee: ECDC ENVIRONMENTAL

Note: If Operator's address, company representative or phone number have changed, please provide a replacement page for the Notice of Intention together with form MR-REV available on the Division's web page at [https://fs.ogm.utah.gov/pub/mines/minerals\\_related/forms/MR-REV.pdf](https://fs.ogm.utah.gov/pub/mines/minerals_related/forms/MR-REV.pdf).

4. Report the gross amount of ore mined and waste moved:

Gross Ore Mined 0 Tons, or 0 yd<sup>3</sup>  
Waste Material Moved 0 Tons, or 0 yd<sup>3</sup>

5. New disturbance created during the year 0 Acres  
Area reclaimed during the year 0 Acres  
Total disturbed area at the end of the year 0 Acres\*

\*The total disturbed area should not be greater than the permitted/bonded acreage

6. Briefly describe the reclamation work performed during the past year. (Submit form MR-SITE ([https://fs.ogm.utah.gov/pub/mines/minerals\\_related/forms/MR-SITE.pdf](https://fs.ogm.utah.gov/pub/mines/minerals_related/forms/MR-SITE.pdf)) to apply for full or partial bond/site release). Attach additional sheets if needed.

N/A

7. Include an updated map depicting surface disturbance and reclamation performed during the year (Rule R647-4-105).

I hereby certify the information provided in this report is true and correct to the best of my knowledge and belief.

Name (Typed or Print): DARIN OLSON

Title of Operator: EM


Signature of Operator: D Olson

Date: 9-23-2014



DRAWN BY:  
I. Johnson  
CHECKED BY:

DATE  
October 1, 1989  
SCALE:  
NTS  
JOB NO.  
047  
DRAWING NO.

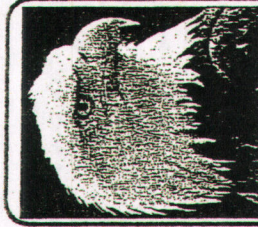


Talon Resources  
Technical  
Group


375 South Cartham Ave.  
Price, Utah 84501  
Phone (435) 637-5032 ex711  
FAX (435) 637-7336

ECDC  
ENVIRONMENTAL  
Clay Mine Site  
Vicinity Map

EXHIBIT  
II

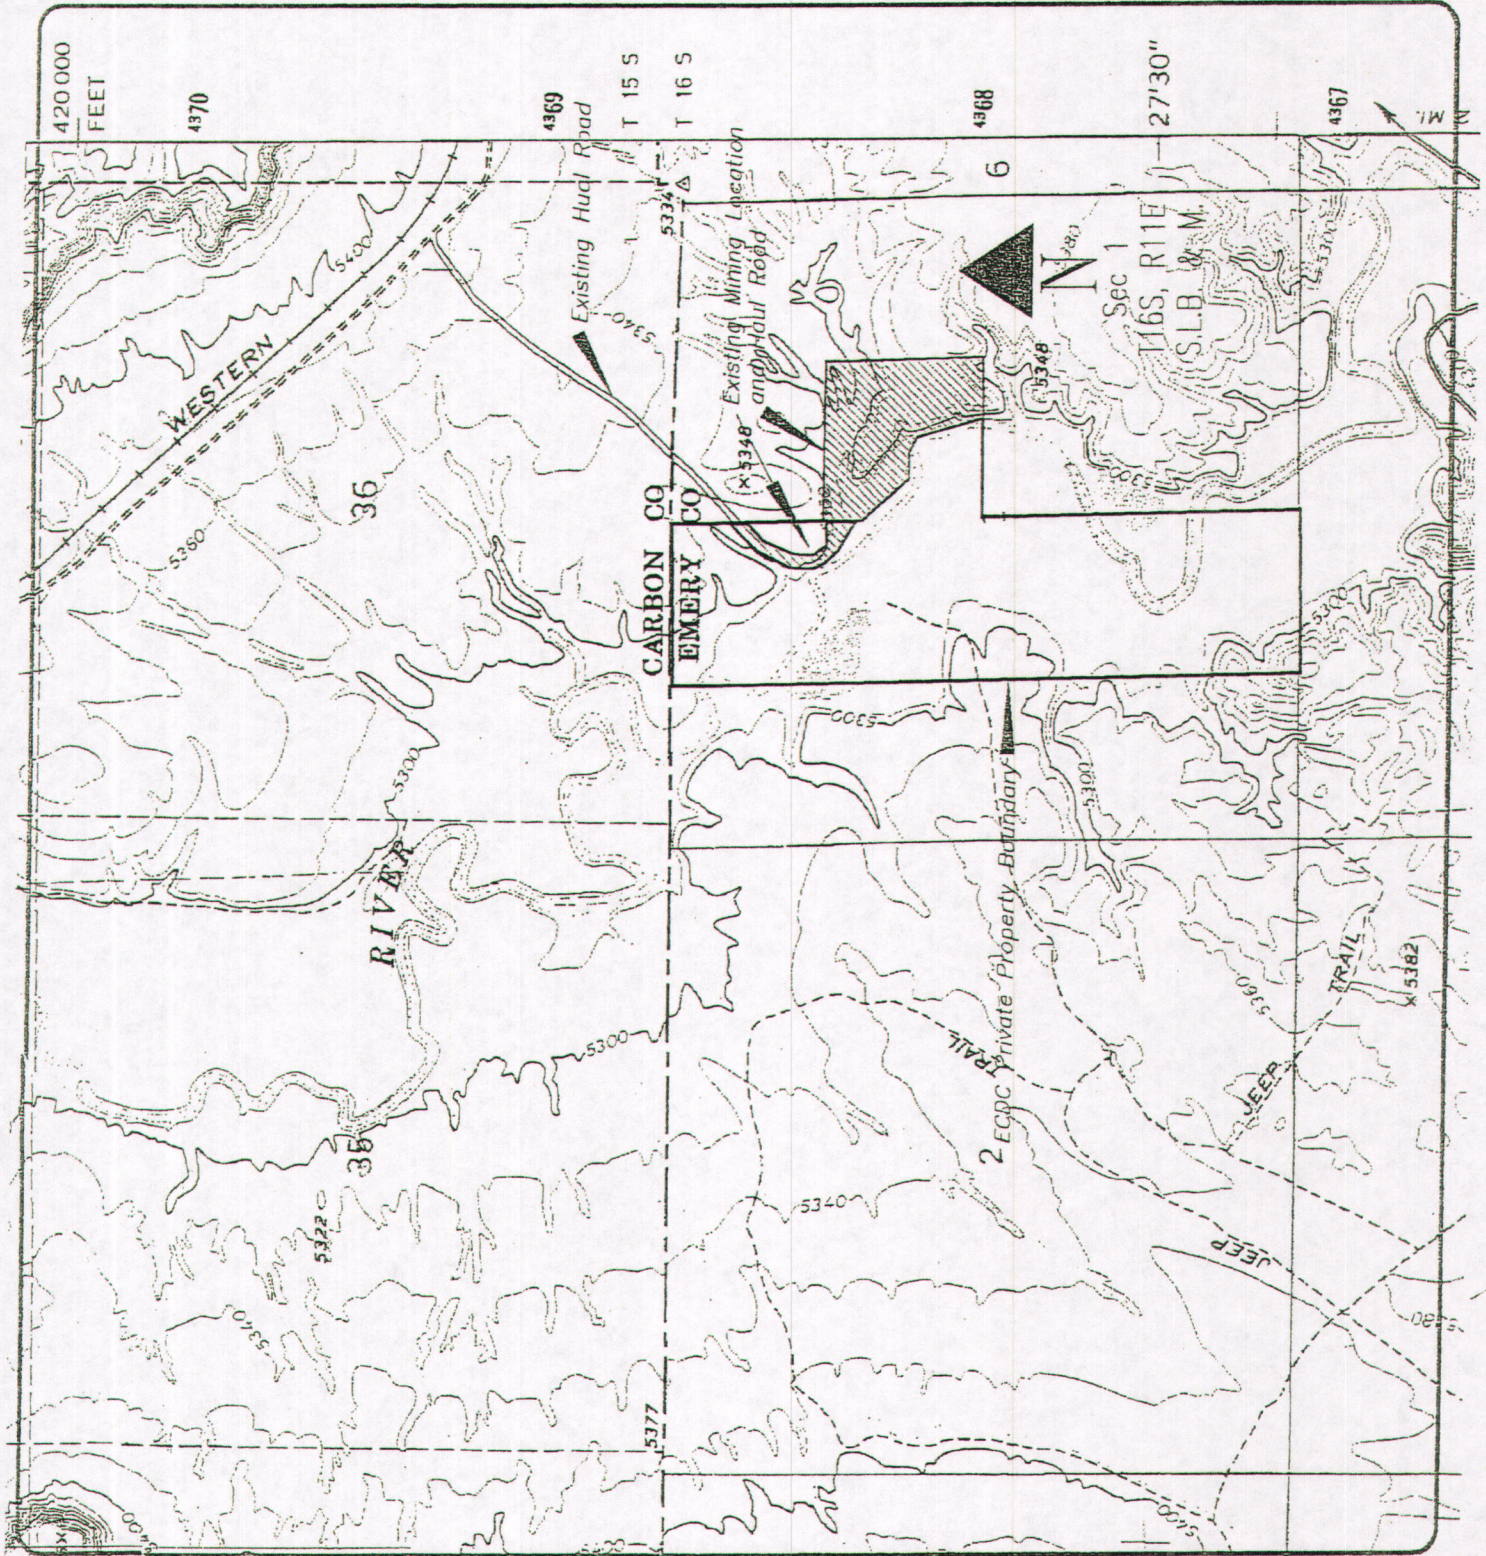



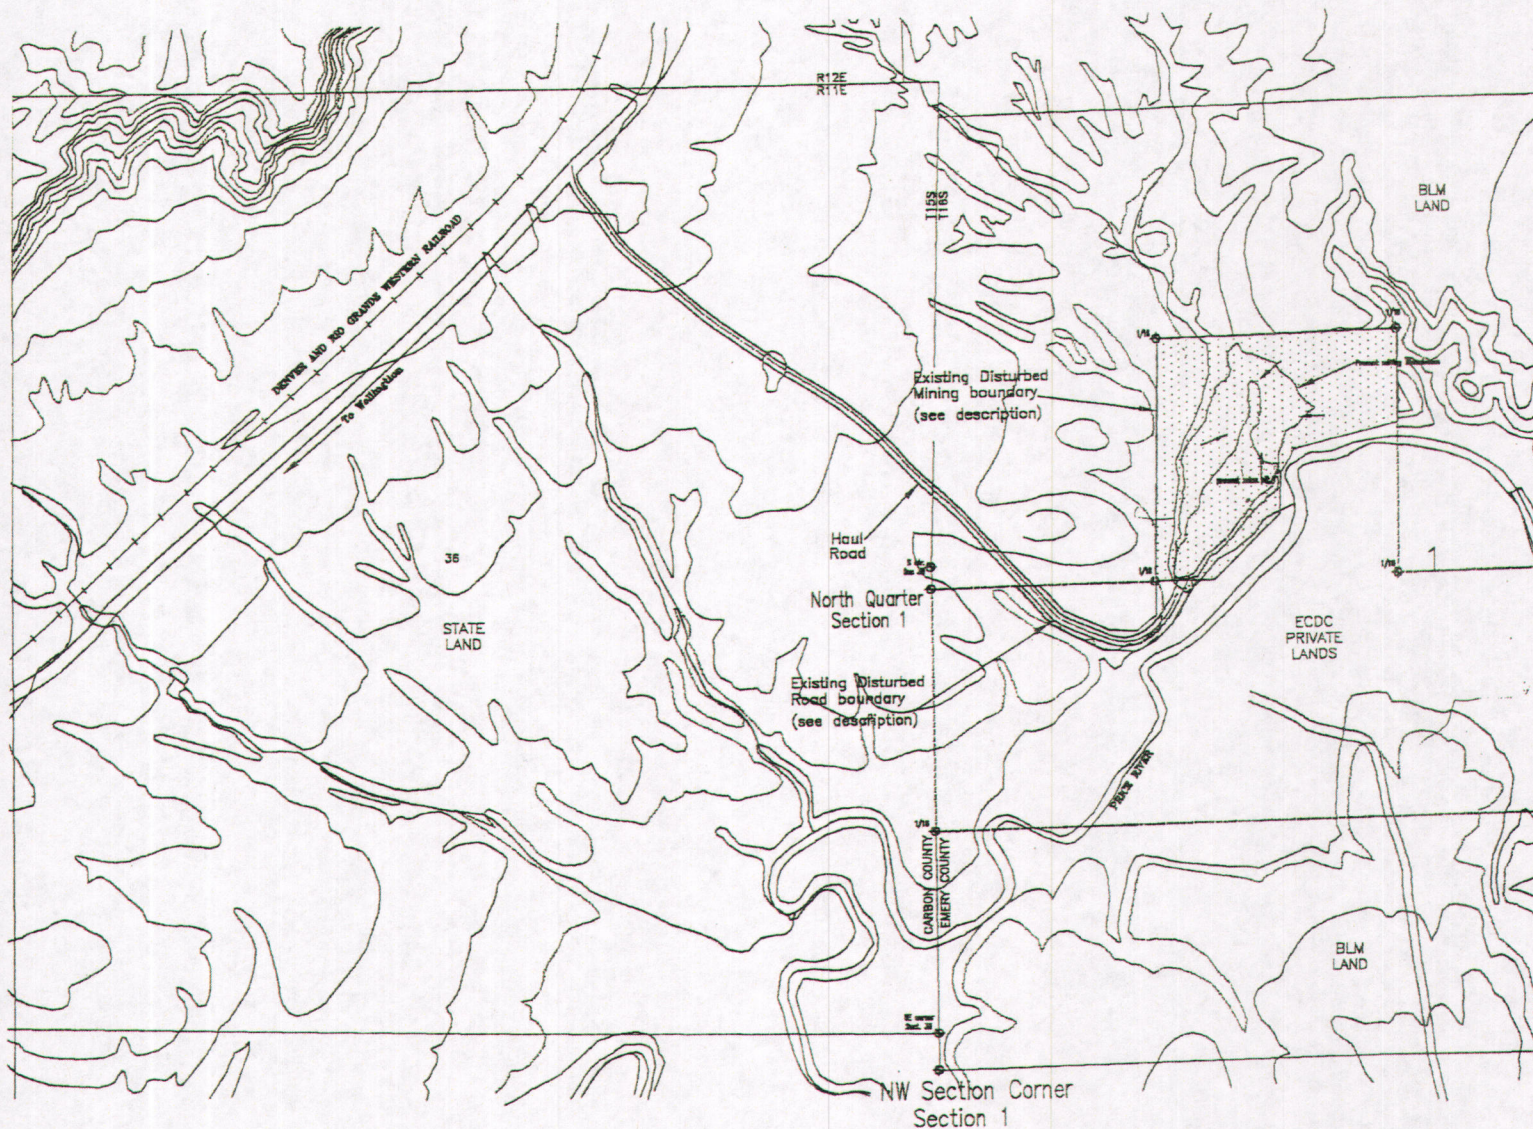

Existing Road Area  
Description of Disturbed Boundaries

Beginning at the NW 1/16 Corner of the SW quarter of the NE quarter of Section 1, T16S, R11E, SLBM, thence S00°22'11"E 241.82'; thence N58°56'12"W 279.66'; thence N42°16'06"W 140.23'; thence N27°40'53"W 119.15'; thence N02°32'52"E 192.59'; thence N26°21'10"E 326.47'; thence N46°33'55"E 300.77' to the property line; thence S01°07'29"E along said property line 138.03'; thence S46°14'33"W 197.51'; thence S23°35'47"W 275.32'; thence S02°55'37"W 163.11'; thence S36°50'52"E 142.08'; thence N90°E 181.06' to the Point of Beginning consisting of 3.15 acres more or less.

Existing Mining area  
Description of Disturbed Boundaries

Beginning at the NW 1/16 corner of the SW quarter of the NE quarter of Section 1, T16S, R11E, SLBM, thence running S88°42.5'E 1363.56' to the NE 1/16 corner of the SW quarter of the NE quarter of Section 1, thence S00°54.5'E, 1342.77' to the SE 1/16 corner of the SW quarter of the NE quarter of Section 1, thence N9°35'W 521.54', thence N14°03'51"W 604.19', thence N61°26'21"W 150.28', thence N89°00'51"W 228.67', thence N45°03'33"W 517.42', thence N01°47'44"E 342.36' to the point of beginning, containing 29.6 acres more or less.